



ASHUGANJ 450 MW CCGP (NORTH)
CIRCULATING WATER PUMP DATA SHEET
 KKS No: 20PAC10AP001


Rev: 5
 Issue Date: 27.03.2015

Inspection and Testing: (9)	Required	Witnessed	Test Code	Requirements
Hydrostatic Test		X		Hydrostatic Pressure Test / Test time: 1,5 MAWP / 30 minutes
Performance Test - Run test		X		At least 5 points
Submergence test		X		
Vibration measurements		X		During Performance Test
Bearing temp. measurements		X		During Performance Test
Noise measurements		X		During Performance Test
Motor Routine Test		X		
Motor Type Test	X			

OTHER REQUIREMENTS:

Painting according to the applicable specification. Painting reports shall be delivered.

ARRANGEMENT AND DIMENSIONS:

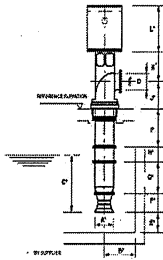

ELEVATION DATA	
REFERENCE	9,2 m (PWD) El 99550mm
MAXIMUM LIQUID LEVEL	7,4 m (PWD) El 97730mm (11)
NORMAL LIQUID LEVEL	6,2 m (PWD) El 96530mm (11)
MINIMUM LIQUID LEVEL	0,76 m (El 91110mm) (11)
SUMP BOTTOM	-5,9 (2) (El 84450mm)

Specification	A	B	C	D	E	F	G	H	I	J	K	L	M	Notes
Seller	2534	1990	5915	1576	845		14255			1676	3474	3260		

REMARKS

- (1) For cooling water quality refer to technical specification, Document No 07485-20-PAC-MIP-TRE-008
- (2) Deleted
- (3) Elevation of the baseplate is +9,2m
- (4) Plant elevation 100000 corresponds to ground level elevation +9,85m MSL (PWD)
- (5) According to IAP and Specification applicable
- (6) Flange Class: AWWA C207
- (7) Viewed from the drive to the pump
- (8) The first critical speed of pumps and motors shall be at least 125% the operating nominal speed.
- (9) The instrument and control equipment shall be designed in accordance with Instrumentation and Control Requirements for Package Units (07485-20-YY_YR_TRE-007) and technical specification
- (10) Operational conditions can add a maximum of 3°C to the peak temperature.
- (11) Deleted
- (12) TDH has been calculated referred to minimum water level, taking into account the difference between suction and discharge elevation. TDH is the total dynamic head calculated as discharge - suction pressure referred to the same elevation.
- (13) Operating point for maximum water level and minimum water level in accordance with the resistant curves attached to this data sheet.
- (14) Deleted

For Reference Only

Te

RAL

Rev		ASHUGANJ 450 MW CCPP (NORTH)				Rev: 5	
		CIRCULATING WATER PUMP DATA SHEET				Issue Date: 27.03.2015	
		KKS No: 20PAC10AP001					
GENERAL							
Applicable to:	Bid	Purchase			As Built		
Project:	ASHUGANJ 450 MW CCPP (NORTH)	Location:	Ashuganj, Bangladesh	Customer:	Ashuganj Power Station Company (APSC)		
KKS:	20PAC10AP001	Service:	Circulating Water Pump	Quantity:	1X 100%		
Mfr:	FLOWERVE	Model:	57 APM	Size & Type:	Vertical Wet Pit		
Stages:	1	Driver supplied by:	Pump Seller	Driver Mounted by:	Pump Seller		
DESIGN CONDITIONS:							
Pumped Fluid: Raw water (1)				Environmental Conditions			
Min / Normal (NT) / Max Temperature	°C	15 / 32.2 / 38 (10)		Barometric pressure nom	Pa	101300	
Vapor Pressure at NT	bara	0.048		Ambient temperature Min / Norm / Max	°C	8 / 35 / 40	
Density at NT	kg/m3	994.967		Min / Normal / Max. Relative Humidity	%	35 / 98 / 100	
Viscosity at NT	mm2/s	0.765		System design conditions			
pH	(1)			Pressure (2)	bara	4.8-1	
Seismic Factor:	Bangladesh National Building Code Seismic zone 3			Temperature (2)	°C	42	
Design Codes:	Hydraulic Institute (HI)		Liquid level min / norm / max (PWD) (4)		m	7.38 / 6.2 / 0.76	
Location:	Indoor	Outdoor	X	Sump depth (PWD) (3) (4)	m	-5.9	
OPERATING AND PERFORMANCE CONDITIONS:							
			Minimum Flow	Operating Point min water level (13)	Operating Point max water level (13)	Design Point	Runout
4	Flow	m3/h	28000	35000	39300	35820	43000
5	TDH (12)	m	26.6	23.1	19.3	22.3	15.8
3	Discharge Pressure	bara	1.61 at LWL	1.26 at LWL	0.89 at LWL	1.19 at LWL	0.58 at LWL
4	Pump Efficiency	%	76	84.5	83.2	85	77.2
4	NPSH required	m	8.7	9.5	10.4	8.8	13.3
4	Submergence required	m	3.1	3.1	3.2	3.1	4.5
4	Brake Horsepower	KW	2657	2600	2472	2548	2394
2	NPSH available at minimum liquid level	m	14.7 (at LWL)	14.7 (at LWL)	21.3 (at HWL)	14.7 (at LWL)	14.7 (at LWL)
2	Submergence available from the minimum liquid level to inlet	m	5.81 (at LWL)	5.81 (at LWL)	5.81 (at LWL)	5.81 (at LWL)	5.81 (at LWL)
3	TDH at shut off condition	m	40.1				
1	Discharge pressure at shut-off condition	bara	3.6 at HWL				
3	Flow at BEP / Efficiency	m3/h / %	36975				
	Speed	rpm	371				
	Critical speed (8)	rpm	> 484				
	Maximum allowable reverse speed	rpm	556.5				
	Maximum achievable reverse speed	rpm	556.5				
	Maximum operation time at shut-off conditions	s	30				
	Rotation viewing the pump from the driver end	CW/CCW	CCW				
	Noise level 1 m away from the pump	dBA	<85				
CONSTRUCTION DATA:							
Pump length measured from baseplate (m)							
L (pump):	NA	L (pump+bell):	4.255	Arrangement	Non Puffout Construction	X	
Pump intake dimensions							
3	Distance from the back wall to the pump bell centerline (mm)	1900	Rated (mm)	1175	Min (mm)	1018	Max 1258
	Distance between the inlet bell and floor (mm)	845	Impeller type	Enclosed	Seriesopen	Open	
	Inlet bell outside diameter (mm)	2534	Bearings	Lineshaft	Sleeve	Ball	
Nozzle Connections							
	Size	Rating	Facing (6)	Location	Quantity	6	
Discharge	66"	AWWA C207 Table 2 Class B	Flanged End	Above soleplate	Lubrication type	Product Water	
Auxiliary connections							
	Quantity	Size	Type	Expected life	40000h		
1	Vent connection	1	6"	ANSI 16.5 Cl.150 RF	Shaft Sealing		
2	Discharge pres. Gauge	1	1/2"	NPT	Type	Mechanical seal X Packing	
2	Coupling				Manufacturer / Model	Flowserve / ALLPAC 480	
	Type	Flexible	Rigid	Spacer	Guard OSHA	Material As per Bill of Material in Seal GA drawing	
5	Manufacturer	JAURE	Model:	MTV-0275, B01, B01	Sealing fluid	Pumped Fluid X	External
	Anchor bolts	Information Supply			Sealing flushing plan	API Plan 13	
	Baseplate	Driver pedestal / Head Soleplate					
PUMP MATERIALS (14):							
	Inlet Bell	ASTM A36		DRIVER:		Manufacturer: HYUNDAI Power: 2950	
	Casing	ASTM A36		Speed:	371	Efficiency: 95%	
	Bowls	NA		Voltage:	6.6 kV	Phase/Frequency: 3/50 Hz	
	Impellers	ASTM A743 CA6NM		Insulation:	Class F	Temperature rise: Class B	
	Diffusers	NA		Applicable spec:	07485-20-BBX-EIP-TRE-001	IP: SS	
	Shaft	ASTM A276 Ty 410 Cond. T		MECHANICAL DATA:			
	Column	ASTM A36		Moment of inertia WR2: 460 Kg.m2			
	Discharge elbow/head	ASTM A36		Torque			
1	Casing wear rings	ASTM A743/A743M CA15		5	Nominal Pump Torque	65000 N.m	
1	Impeller wear rings	ASTM A743/A743M CA15		5	Maximum torque required during starting	68300 N.m	
	Shaft sleeves	ASTM A276 Ty 410		5	Maximum torque which pump is able to withstand	68300 N.m	
	Radial Bearings	RUBBER - Bronze Backed		5	Maximum torque in runout conditions	61400 N.m	
	Bolting	ASTM A307 Gr. B		Max. applic. transient taking into account safety NA N.m			
	Wet Bolting	AISI 410		Forces (N) and moments (N.m)			
	Auxiliary piping	316L		Inlet Nozzle Fx Fy Fz Mx My Mz			
	Soleplate	ASTM A36		Outlet Nozzle 30110 27152 33500 34496 42651 29241			
				Thrust (at the coupling) Maximum (N) Continuous (N)			
				Downward 261100 250850			
2	WEIGHTS:	Pump (kg): 30800	Motor (kg): 25000	Upward 87040 83620			
2		Soleplate (kg): 995 (Included in 30800 kg) Total (kg): 55800					

Handwritten signature

Handwritten mark

HEAVY INDUST



3-INDUCTION MOTOR


STANDARD : IEC60034-1

2950 KW	16 P	6600 V	357.4 A	50 Hz
FRAME SIZE	800	ROTOR TYPE	SQUIRREL CAGE	
TYPE	HRN3 807-76Y	DUTY TYPE	S1	
PROTECTION DEGREE	IP 55	SERVICE FACTOR	1.0	
SPEED AT FULL LOAD	370 r.p.m	INSULATION CLASS	F	
AMBIENT TEMP.	40 °C	TEMPERATURE RISE	B Class	
EFFICIENCY	95 %	POWER FACTOR	0.76	
BEARING(D.E)	6052M	BEARING(N-D.E)	7340BDT	
SPACE HEATER			230 V	
WEIGHT	25000 kg		1000 W	
SERIAL NO.	20143304RMHB77001	CODE LETTER	F	
COOLING TYPE	IC81W	MANUFACT'G DATE	2015.02	
		MOMENT OF INERTIA(J)	1002 kg·m ²	

MADE IN KOREA

4M-077056

CAUTION BEARING INSTALLATION

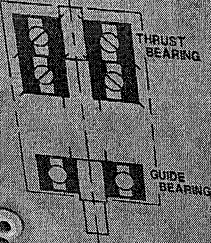

BEARING INSTALLATION IS ARRANGED AS LEFT FIGURE. BE CAREFUL OF ARRANGEMENT OF THRUST BEARING IN CASE OF REASSEMBLY OR VERTICAL MOUNTING CHANGE.

4M-070169

LUBRICATION INSTRUCTIONS

	INITIAL SUPPLY	RESUPPLY	RESUPPLY INTERVAL
D.E SIDE	1240 GR		
N-DE SIDE	4032 GR	130 GR	
		1210 GR	4 MONTHS

THIS MOTOR WAS LUBRICATED AT FACTORY WITH SHELL GARDOL S2 V165 S. IF A DIFFERENT LUBRICANT IS TO BE USED FOR PERIODIC MAINTENANCE, COMPATIBILITY MUST FIRST BE VERIFIED.

4M-064280

TO PR
IS PRO
END SH


D.E

END

Handwritten signature

Handwritten mark


ACC'Y T/BOX WIRING DIAGRAM

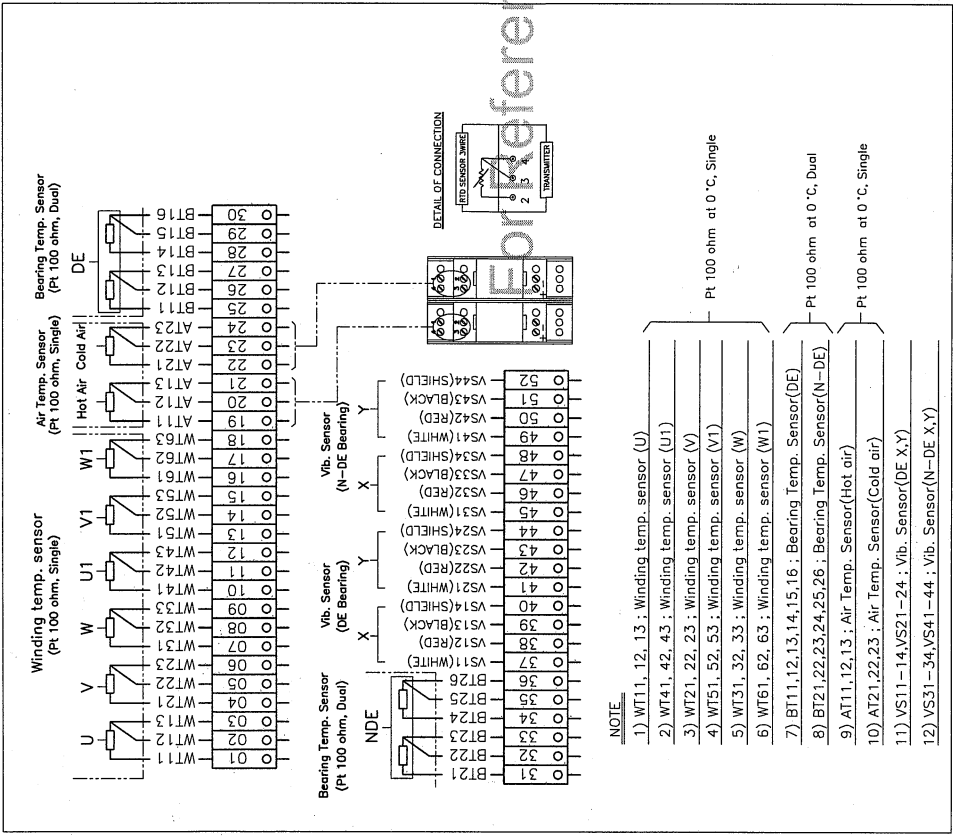

NOTE.

- 1) WT11, 12, 13 : Winding temp. sensor (U)
- 2) WT41, 42, 43 : Winding temp. sensor (U1)
- 3) WT21, 22, 23 : Winding temp. sensor (V)
- 4) WT51, 52, 53 : Winding temp. sensor (V1)
- 5) WT31, 32, 33 : Winding temp. sensor (W)
- 6) WT61, 62, 63 : Winding temp. sensor (W1)
- 7) BT11,12,13,14,15,16 : Bearing Temp. Sensor(DE)
- 8) BT21,22,23,24,25,26 : Bearing Temp. Sensor(N-DE)
- 9) AT11,12,13 : Air Temp. Sensor(Hot air)
- 10) AT21,22,23 : Air Temp. Sensor(Cold air)
- 11) VS11-14, VS21-24 : Vib. Sensor(DE X, Y)
- 12) VS31-34, VS41-44 : Vib. Sensor(N-DE X, Y)


HEATER T/BOX WIRING DIAGRAM

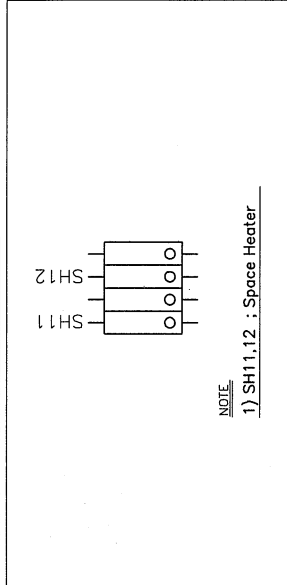

NOTE.

- 1) SH11,12 : Space Heater

LEAKAGE DETECTOR WIRING DIAGRAM

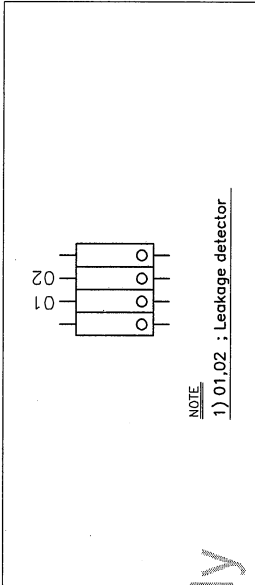

NOTE.

- 1) 01,02 : Leakage detector

*** TAG NO.**

DE BEARING TEMP.	20PACT0AP001JT12A
NDE BEARING TEMP.	20PACT0AP001JT13A
LEAKAGE DETECTOR	20PACT0AP001JH82A
ATD (COLD AIR TEMP.)	20PACT0AP001JT27A
ATD (HOT AIR TEMP.)	20PACT0AP001JT28A
WINDING TEMP. (U)	20PACT0AP001JT21R
WINDING TEMP. (V)	20PACT0AP001JT22S
WINDING TEMP. (W)	20PACT0AP001JT23T
WINDING TEMP. (U1)	20PACT0AP001JT31R
WINDING TEMP. (V1)	20PACT0AP001JT32S
WINDING TEMP. (W1)	20PACT0AP001JT33T
VIBRATION NDE X	20PACT0AP001JT60A
VIBRATION NDE Y	20PACT0AP001JT70A
VIBRATION DE X	20PACT0AP001JT66A
VIBRATION DE Y	20PACT0AP001JT67A

QTY	DESCRIPTION	MATERIAL	DIMENSION	WEIGHT	PART NO.	REMARK	NO.
APPD BY	Y.S.Joo	UNIT	mm	SUBJECT			DWG SIZE
CHKD BY	Y.G.Kwon	SCALE	NON SCALE	TITLE			A3 (1:5)
CHKD BY	Y.S.Cha	PROJEC'N	3 P (3rd Angle)	WIRING DIAGRAM			
DSND BY	Y.S.Cha	DATE	2014-10-24				
REF. NO		DWG NO		3M-133804		Sheet No. of	
						Revision No. △	



REV	DATE	CONTENTS	REVD BY	CHKD BY	APPD BY
△ 15.02.13		Revised as mark	H.K.LEE	S.H.Park	J.B.Kim
					H.C.Kim

27

Handwritten signature

이 도면은 본 회사의 영업비밀로 취급되며, 무단으로 복제, 배포, 전수, 또는 기타 방법으로 제3자에게 유출될 경우 법적 책임을 지게 됩니다. (This drawing is the company's trade secret and will be treated as such. It is prohibited to copy, distribute, transfer, or disclose it to a third party by any means without the company's permission.)



THIS DRAWING IS PROPRIETARY TO HIL. NO PART OF THIS DRAWING MAY BE REPRODUCED WITHOUT THE PERMISSION OF HIL.

QTY	DESCRIPTION	MATERIAL	DIMENSION	WEIGHT	PART NO.	REMARK	NO.
1	SUPPORT	SS400					1
1	SO. TUBE (HOUSING)	SS400					2
1	SENSOR ASSY	-	FLOAT TYPE (RSFS4Y1) (DRY / B) - (ENERGY 3M-17/5B65)				3
1	JUNCTION BOX	SUS316					4
1	SIGHT GLASS	SUS316					5
1	WATER IN CONDUCTOR	SUS316					6
1	DRAIN HEX. PLUG	SUS316	PT 1/4"				7
1	PACKING	NBR					B
1	SENSOR CABLE GUARD PIPE	SUS316	T2 x ø13				9
1	EARTH PLATE	SUS316	T1 x 20				10

* TAG NO.
20143304RMHB77001 20PAC10AP001GA003

CONTACT : NO
CONTACT RATING ;
DC Max. 120V, 0.6A

PROTECTION DEGREE : IP65

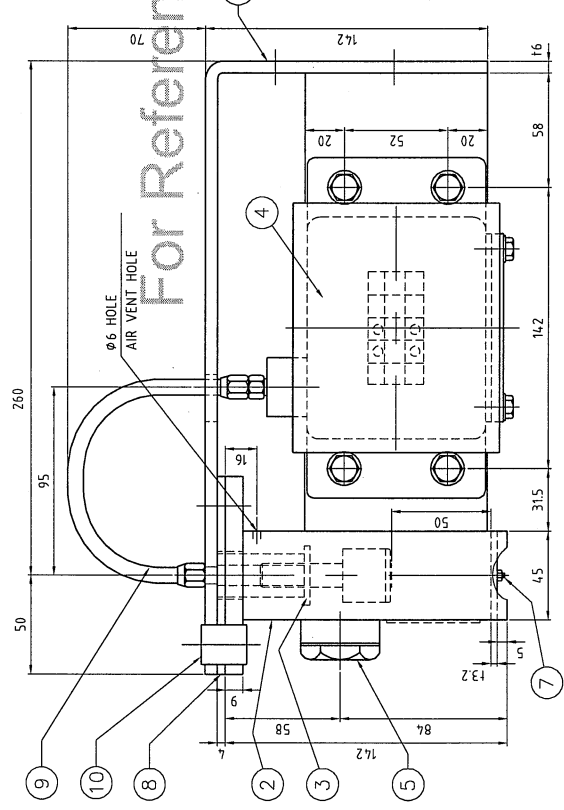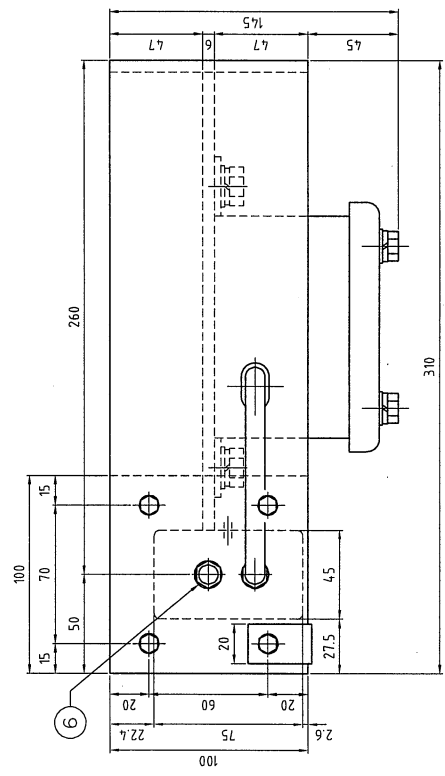



For Reference Only

QTY	DESCRIPTION	MATERIAL	DIMENSION	WEIGHT	PART NO.	REMARK	NO.
APPD BY	Y.S. Joo	UNIT	mm				
CHKD BY	Y.S. Cha	SCALE	Non Scale				
CHKD BY	---	PROJEC N	3 (3rd Angle)				
DSND BY	Y.G. Kwon	DATE	2014-10-10				
TITLE							
LEAKAGE DETECTOR							
REF. NO							3M-098713
DWG NO							3M-185935
Sheet No.							of
Revision No.							1

HYUNDAI
HEAVY INDUSTRIES CO., LTD.

REV	DATE	REVISION OF MARK	REVISION OF CONTENTS	REVD BY	CHKD BY	APPD BY	REVISION OF MARK	REVISION OF CONTENTS
1	2015.02.13			H.K. LEE	Y.G. KWON	---		
2								
3								
4								
5								
6								
7								
8								
9								

Handwritten signature

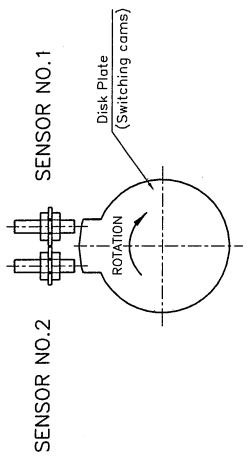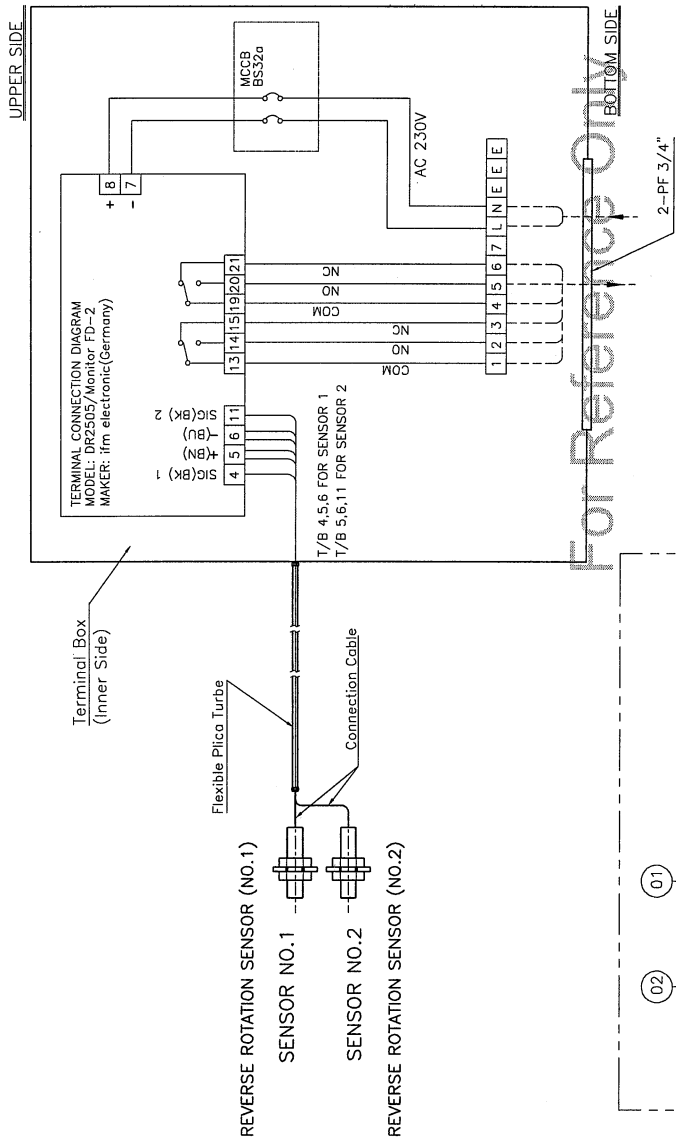


Typical Sensors Location (VIEW FROM DE SIDE)

CABLE CONNECTION SCOPE
 - - - - - Not in IHH scope
 _____ HYUNDAI Scope

PROTECTION DEGREE : IP65

NO.	DESCRIPTION	MATERIAL	Q.TY
05	EARTH STUD	-	1
04	CABLE GLAND PLATE	SUS316L	1
03	GASKET	SILICONE	1
02	PLATE	-	1
01	TERMINAL BOX	SUS316L	1

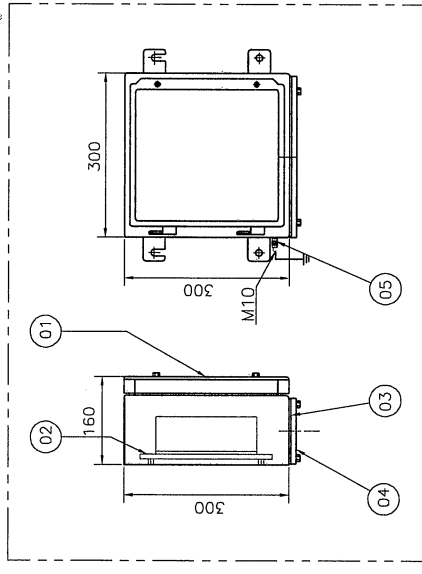

QTY	DESCRIPTION	MATERIAL	UNIT	SCALE	DATE	PROJECTN	PROJECN	DATE	PROJECN	DATE	PROJECN	DATE	PROJECN	DATE
	APPD BY	Y.S.KOO												
	CHKD BY	J.B.KIM												
	CHKD BY	H.K.LEE												
	DSND BY	J.Y.KIM												


REF. NO	DWG NO	SHEET NO	TOTAL SHEETS
2M-090244	2M-090244	0	0

REVERSE ROTA. SENSOR BOX & WIRING DIAGRAM

HYUNDAI HEAVY INDUSTRIES CO., LTD.

REV	DATE	CONTENTS	REV'D BY	CHK'D BY	APP'D BY

Handwritten signature

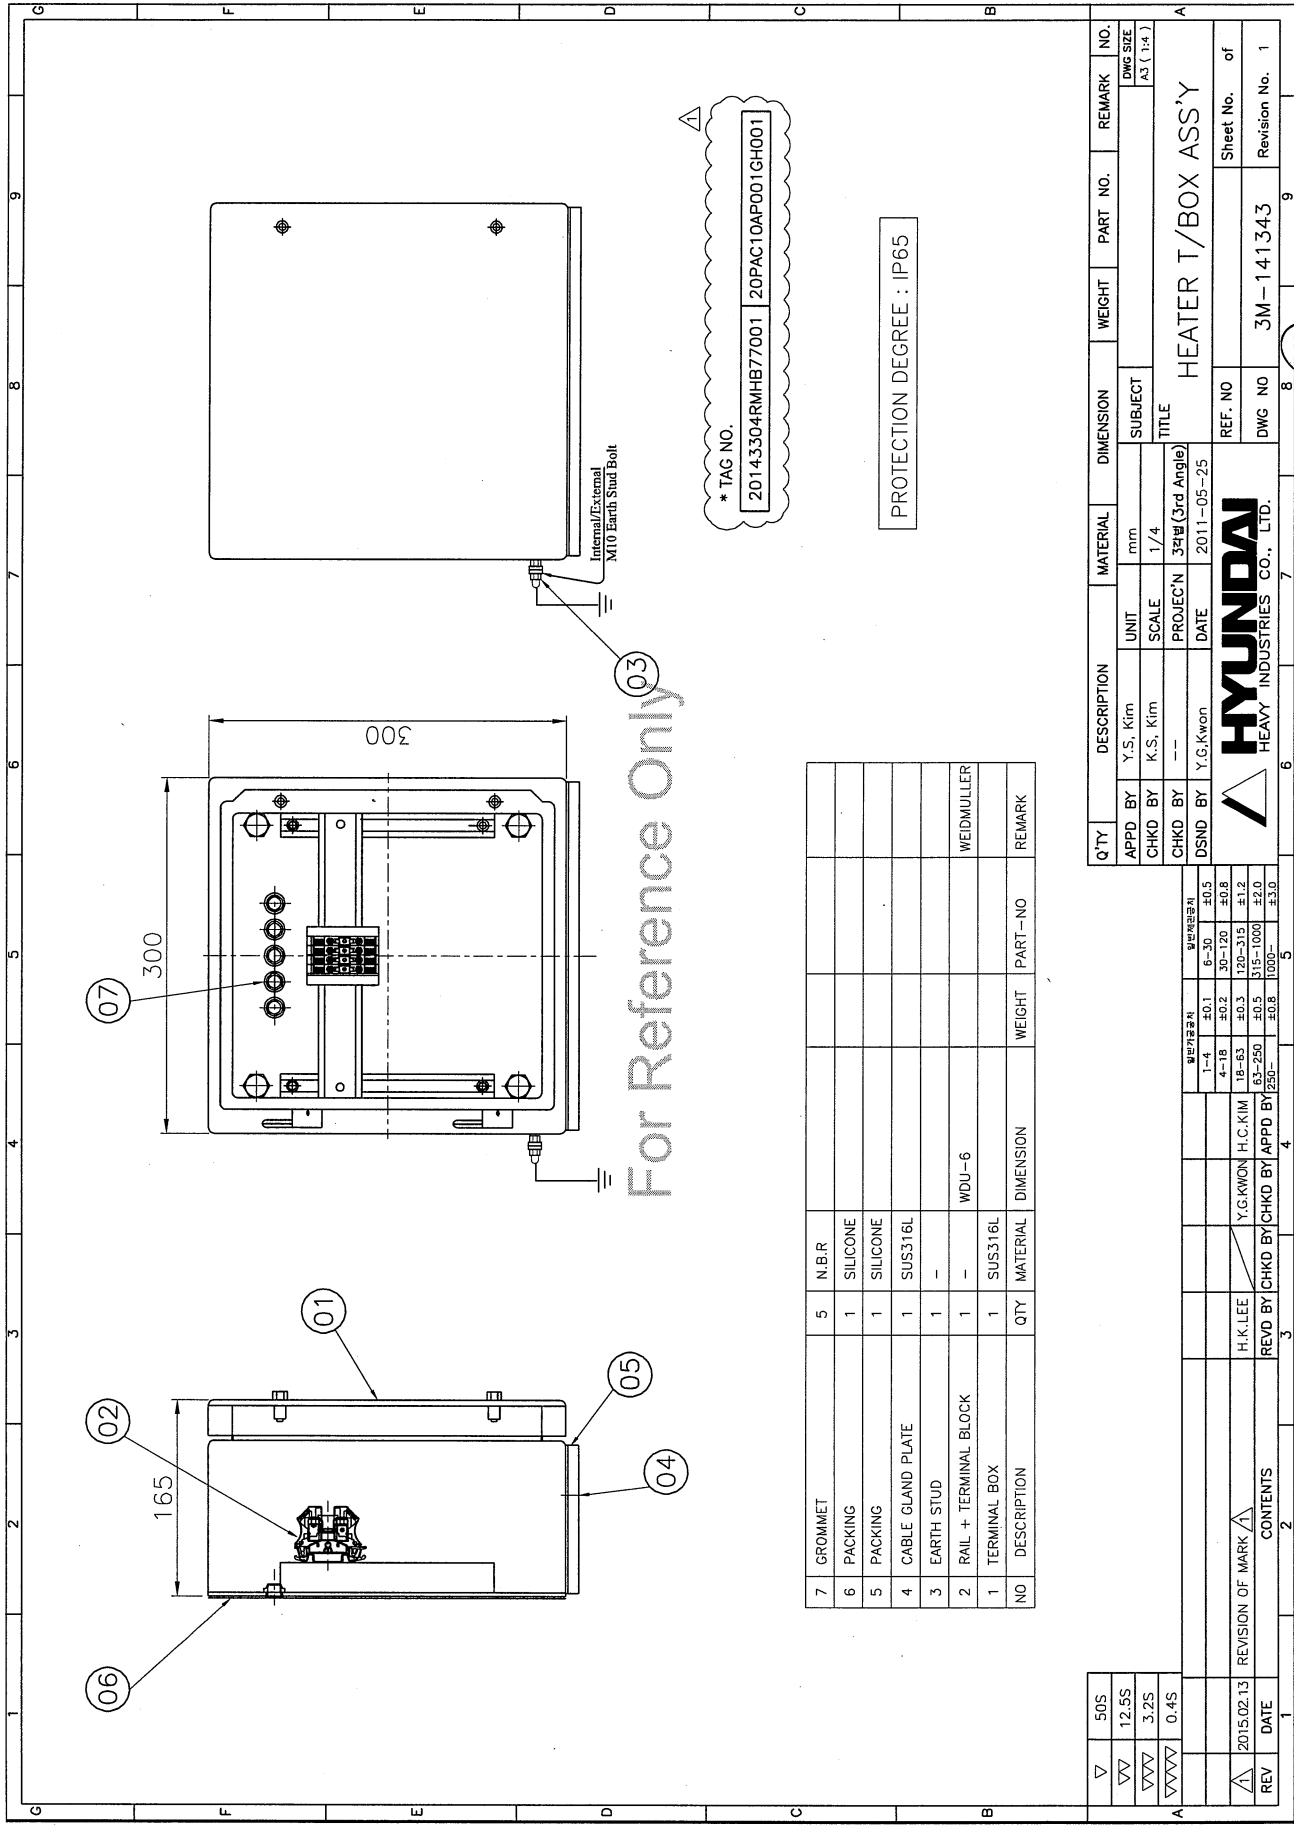

For Reference Only 03

N.O	DESCRIPTION	QTY	MATERIAL	DIMENSION	WEIGHT	PART-NO	REMARK
7	GROMMET	5	N.B.R				
6	PACKING	1	SILICONE				
5	PACKING	1	SILICONE				
4	CABLE GLAND PLATE	1	SUS316L				
3	EARTH STUD	1	-				
2	RAIL + TERMINAL BLOCK	1	-	WDU-6			WEIDMULLER
1	TERMINAL BOX	1	SUS316L				

PROTECTION DEGREE : IP65

* TAG NO.
20143304RMHB7001 20PAC10AP001GH001

▽	50S
▽▽	12.5S
▽▽▽	3.2S
▽▽▽▽	0.4S

REVISION OF MARK	REVISION NO.	DATE
△	1	2015.02.13
CONTENTS	REV	DATE
	1	

Q'TY	DESCRIPTION	MATERIAL	DIMENSION	WEIGHT	PART NO.	REMARK
APPD BY	Y.S. Kim	UNIT	mm			
CHKD BY	K.S. Kim	SCALE	1/4			
CHKD BY	--	PROJEC'TN	3차원 (3rd Angle)			
DSND BY	Y.G.Kwon	DATE	2011-05-25			
TITLE			HEATER T/BOX ASSY			
REF. NO			Sheet No. of			
DWG NO			3M-141343			
Revision No.			1			




Handwritten signature

Handwritten mark

현대중공업 (주) 제1연구소 (주요사업부) (주요사업부)
 현대중공업 (주) 제1연구소 (주요사업부) (주요사업부)

THIS DRAWING IS PROPRIETARY TO HHI. NO PART OF THIS DRAWING
 MAY BE REPRODUCED WITHOUT THE PERMISSION OF HHI.

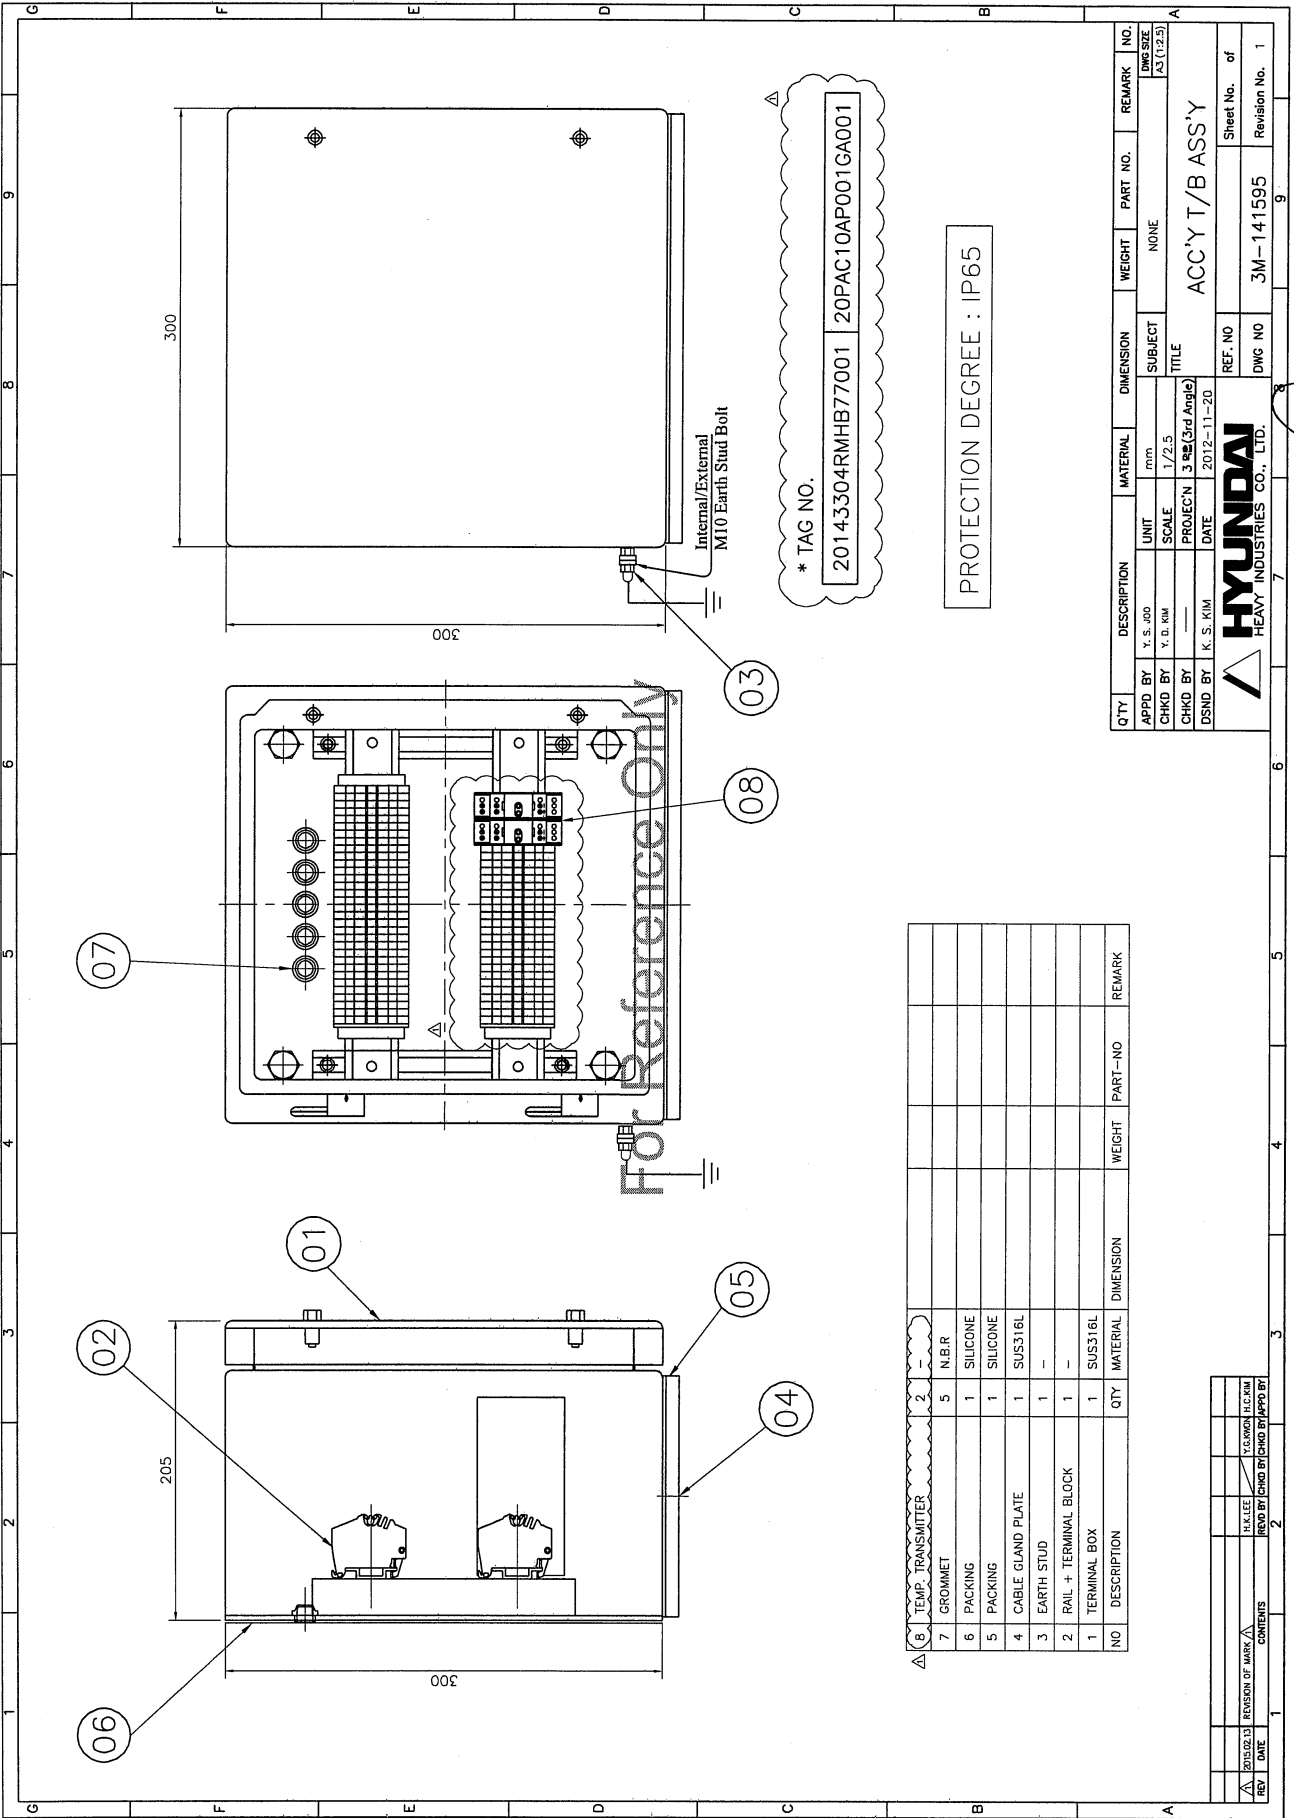

NO	DESCRIPTION	QTY	MATERIAL	DIMENSION	WEIGHT	PART-NO	REMARK
1	TEMP. TRANSMITTER	2					
2	GROMMET	5	N.B.R				
3	PACKING	1	SILICONE				
4	PACKING	1	SILICONE				
5	CABLE GLAND PLATE	1	SUS316L				
6	EARTH STUD	1					
7	RAIL + TERMINAL BLOCK	1					
8	TERMINAL BOX	1	SUS316L				
9	DESCRIPTION						

QTY	DESCRIPTION	MATERIAL	DIMENSION	WEIGHT	PART NO.	REMARK	NO.
APPD BY	Y. S. JOO	mm	SUBJECT	NONE			DWG SIZE A3 (1:2.5)
CHKD BY	Y. D. KIM	SCALE	1/2.5				
DSND BY	K. S. KIM	PROJECN	3 (Std Angle)				
		DATE	2012-11-20				
TITLE							
ACC'Y T/B ASS'Y							
REF. NO							Sheet No. of
DWG NO							3M-141595
							Revision No. 1

REV	DATE	REVISION OF MARK	CONTENTS	REV BY	CHKD BY	APPD BY
1						
2						


HYUNDAI
HEAVY INDUSTRIES CO., LTD.

Handwritten signature

THIS DRAWING IS PROPRIETARY TO HYL. NO PART OF THIS DRAWING MAY BE REPRODUCED WITHOUT THE PERMISSION OF HYL.


HYUNDAI HEAVY INDUSTRIES CO., LTD.

이 도면은 무단복사(주) 저작권법 제 117조의 제 1항에 의해 보호되는 기밀사항입니다.

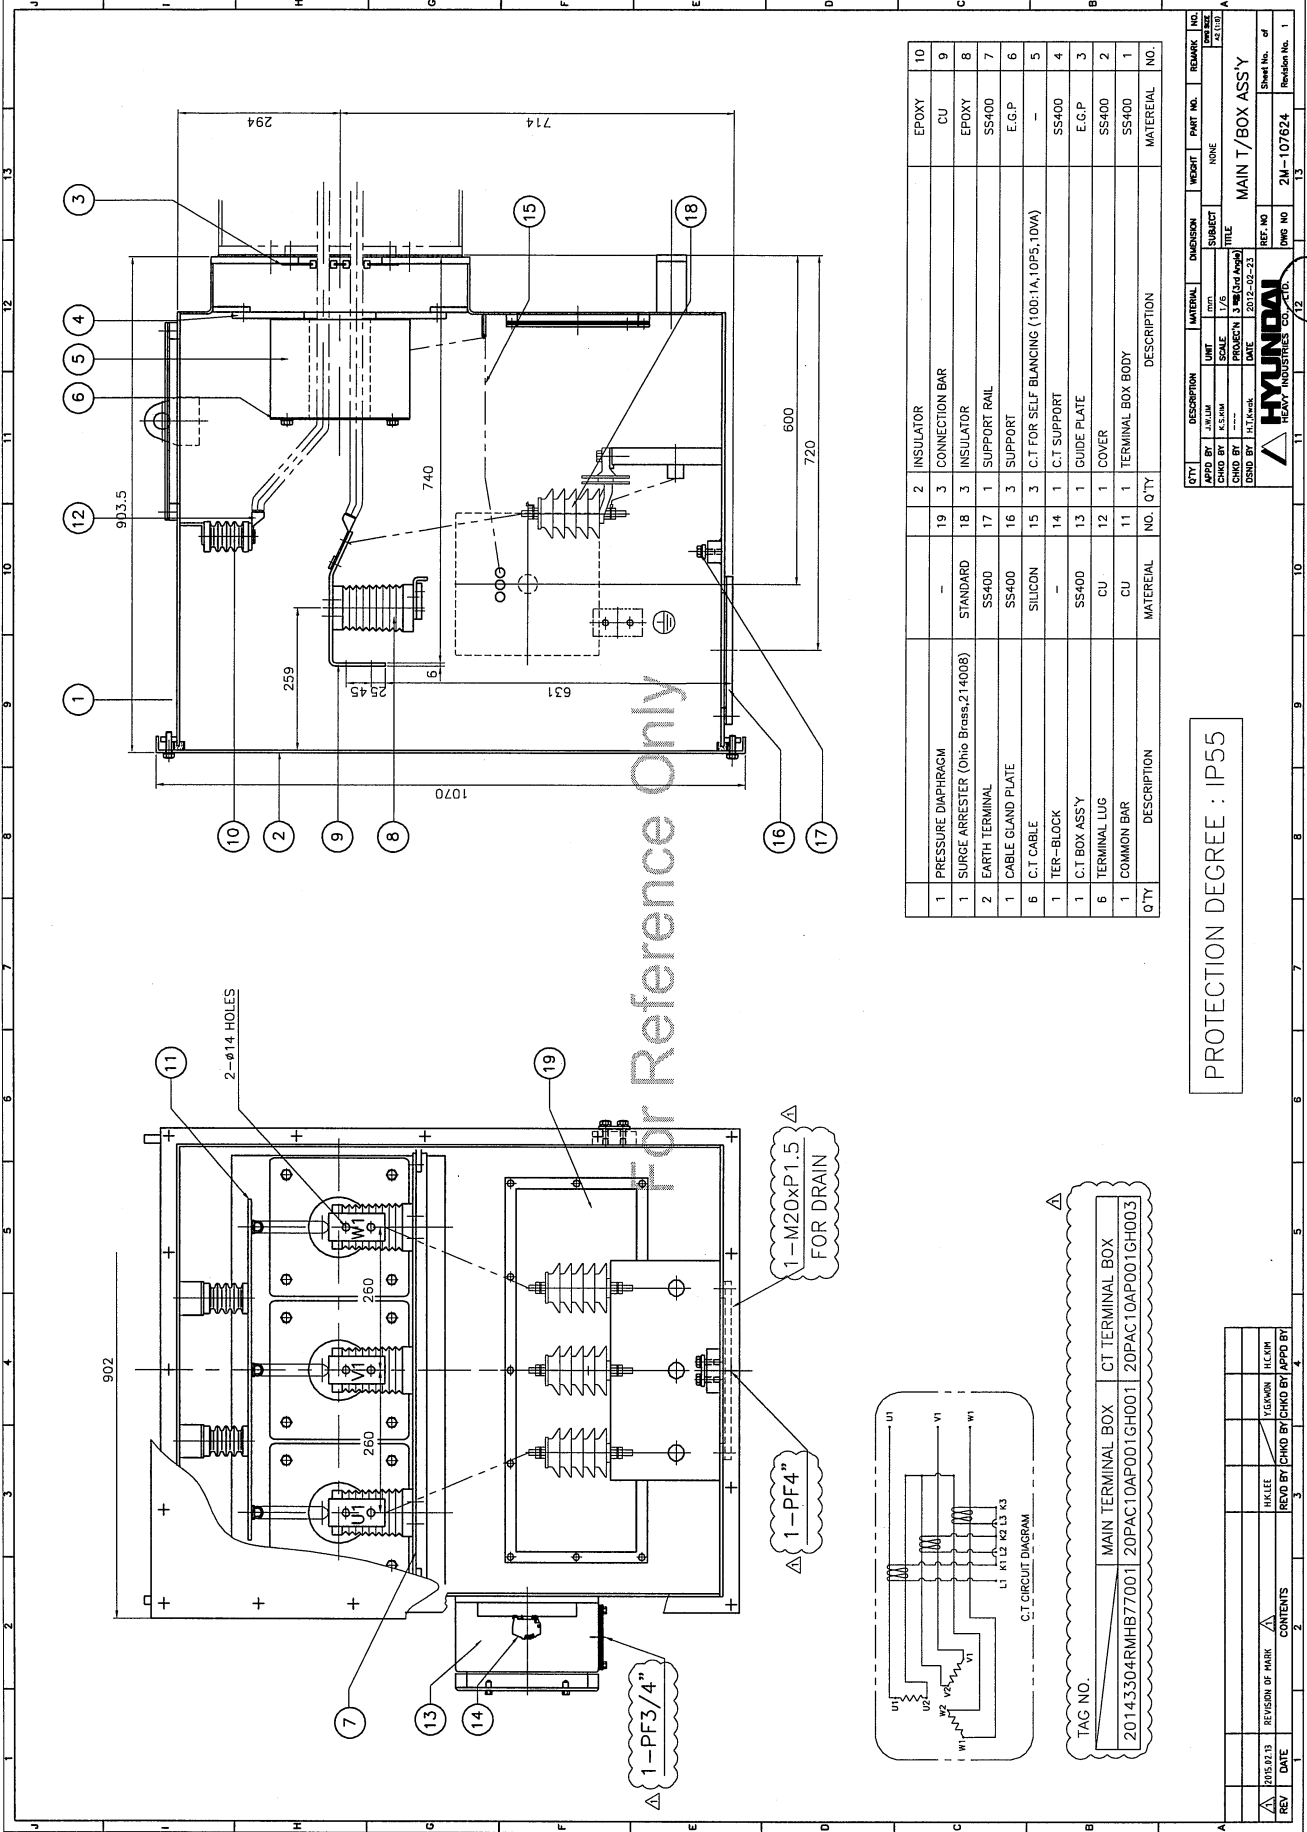

For Reference Only

QTY	DESCRIPTION	MATERIAL	UNIT	WEIGHT	PART NO.	REMARK	IND. NO.
1	PRESSURE DIAPHRAGM						9
1	SURGE ARRESTER (Ohio Brass, 214008)	STANDARD					8
2	EARTH TERMINAL	SS400					7
1	CABLE GLAND PLATE	SS400					6
6	C.T. CABLE	SILICON					5
1	C.T. BLOCK						4
1	C.T. BOX ASSY	SS400					3
6	TERMINAL LUG	CU					2
1	COMMON BAR	CU					1
QTY	DESCRIPTION	MATERIAL	NO.	QTY	DESCRIPTION	MATERIAL	NO.
2	INSULATOR			19	3	CONNECTION BAR	EPOXY
19	3			18	3	INSULATOR	CU
18	3			17	1	SUPPORT RAIL	EPOXY
17	1			16	3	SUPPORT	SS400
16	3			15	3	C.T. FOR SELF BLANCING (100:1A, 10P5, 1DWA)	E.G.P
15	3			14	1	C.T. SUPPORT	
14	1			13	1	GUIDE PLATE	SS400
13	1			12	1	COVER	E.G.P
12	1			11	1	TERMINAL BOX BODY	SS400
11	1						MATERIAL

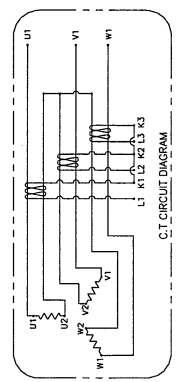


TAG NO.
20143304RMB77001 MAIN TERMINAL BOX CT TERMINAL BOX
20PAC10AP001GH001 20PAC10AP001GH003

PROTECTION DEGREE : IP55

QTY	DESCRIPTION	MATERIAL	UNIT	WEIGHT	PART NO.	REMARK	IND. NO.
1	MAIN T/BOX ASSY						1

REV	DATE	REVISION OF MARK	CONTENTS	REV'D BY	CHK'D BY	APP'D BY
1						

Handwritten signature

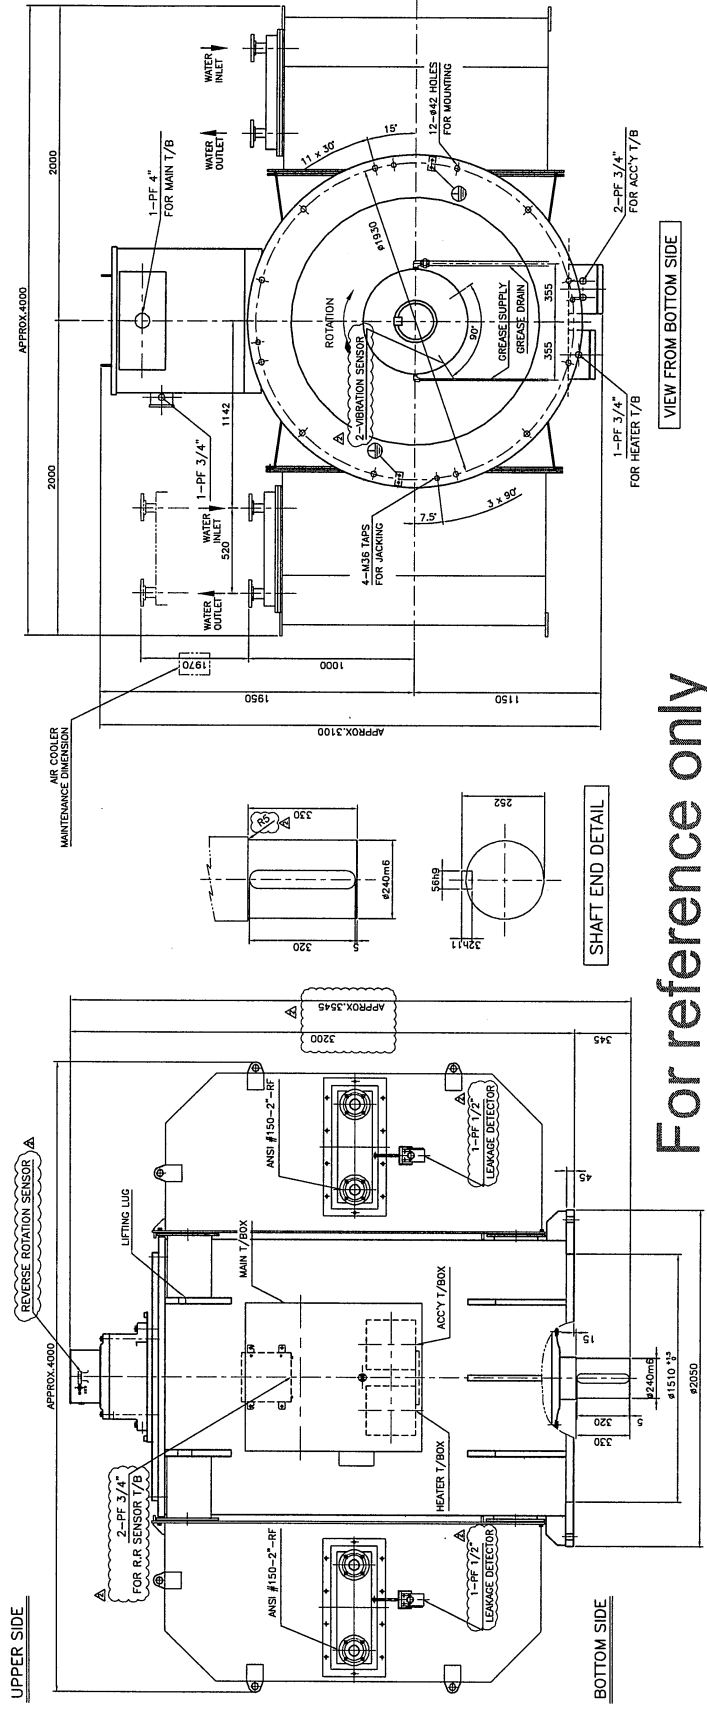

For reference only

THREE PHASE INDUCTION SQUIRREL CAGE ROTOR MOTOR ; IC611

TYPE	OUTPUT	POLES	VOLT.	FREQ.	PROT. CLASS	INSUL. CLASS	MOUNT.	BEARING	TOTAL WEIGHT (APPROX.)
HRN3 807-76Y	2950 kW	16 P	6600 V	50 Hz	IP 55	F	V 10	7340BDT / 6052M	25000 kg

TECHNICAL INFORMATION

- BEARING

BEARING	D.E. SIDE	N-D.E. SIDE
Bearing Type	#6052M (Ball)	7340BDT (Angular Contact Ball)
Lubricant Type	GREASE	GREASE
Grease Type	SHELL(Godius S2 V100-3)	
Initial Charge Quantity	1240 g	4032 g
Refilling Quantity	130 g	1210 g
-Charge Interval	4 MONTHS	4 MONTHS
- WINDING TEMPERATURE DETECTOR

Winding (W.T.D)	Bearing (B.T.D)
Alarm	130 °C
Trip	150 °C
	100 °C
	105 °C
- BEARING TEMPERATURE DETECTOR

Number and Type : 2EA/Phase, Pt 100 ohm at 0°C-Single
- ROTATION SENSOR

Number and Type : 1EA/Bearing, Pt 100 ohm at 0°C-Dual
- AIR TEMPERATURE DETECTOR

Number and Type : 2EA/Motor, Pt 100 ohm at 0°C-Single
- CONTROL SETTING(Included Ambient Temp.):

Setting	Value
Space Heater	1 PHASE, 230 V, 1000W
Water Leakage Detector	2EA/MOTOR
Reverse Rotation Sensor	1EA/MOTOR (IFM, DR2505)
- WINDING TEMPERATURE DETECTOR

Number and Type : 2EA/Phase, Pt 100 ohm at 0°C-Single
- BEARING TEMPERATURE DETECTOR

Number and Type : 1EA/Bearing, Pt 100 ohm at 0°C-Dual
- AIR TEMPERATURE DETECTOR

Number and Type : 2EA/Motor, Pt 100 ohm at 0°C-Single
- CONTROL SETTING(Included Ambient Temp.):

Setting	Value
Space Heater	1 PHASE, 230 V, 1000W
Water Leakage Detector	2EA/MOTOR
Reverse Rotation Sensor	1EA/MOTOR (IFM, DR2505)
- WINDING TEMPERATURE DETECTOR

Number and Type : 2EA/Phase, Pt 100 ohm at 0°C-Single
- BEARING TEMPERATURE DETECTOR

Number and Type : 1EA/Bearing, Pt 100 ohm at 0°C-Dual
- AIR TEMPERATURE DETECTOR

Number and Type : 2EA/Motor, Pt 100 ohm at 0°C-Single
- CONTROL SETTING(Included Ambient Temp.):

Setting	Value
Space Heater	1 PHASE, 230 V, 1000W
Water Leakage Detector	2EA/MOTOR
Reverse Rotation Sensor	1EA/MOTOR (IFM, DR2505)
- VIBRATION SENSOR (Seismic Transmitter)


Number and Type : 2EA/Bearing, Bentley Nevada 177230
- COOLING WATER FOR MOTOR

Quality	Fresh Water
Flow rate	17.0 m ³ /hr
Max. allowable flow rate	22.1 m ³ /hr
Operating Pressure	Max. 10 barg
Inlet Temp.	37.2 °C
Max. allowable Inlet Temp.	39 °C
- CURRENT TRANSFORMER (SELF BALANCE TYPE)

Number and Type : 3EA/MOTOR, CT-eTech, 100/1A, 10P20

CAUTION
To maintain the water cooler of motor in good condition, cooling water shall be provided into the water cooler less than maximum allowable flowrate. In addition, cooling water shall be provided in accordance with cooling water inlet pressure. Otherwise, the water cooler will be seriously damaged.

KKS NO.: 20PAC1DAP001

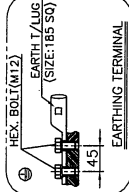

REVISION NO.	DATE	BY	CHK	DESCRIPTION
1	2014-03-09	Y. KIM		INITIAL DESIGN
2	2014-03-09	Y. KIM		REVISION OF MARK
3	2014-03-09	Y. KIM		REVISION OF MARK
4	2014-03-09	Y. KIM		REVISION OF MARK

SCALE	UNIT	PROJ. NO.	DESIGN NO.	REV. NO.	REV. DATE	REV. DESCRIPTION
1/4	MM	2014-03-09	2014-03-09	1		

REVISION NO.	DATE	BY	CHK	DESCRIPTION
1	2014-03-09	Y. KIM		INITIAL DESIGN
2	2014-03-09	Y. KIM		REVISION OF MARK
3	2014-03-09	Y. KIM		REVISION OF MARK
4	2014-03-09	Y. KIM		REVISION OF MARK

For reference only

CHARACTERISTICS	REQUIRED	PROPOSED
Establishment of speed-torque, speed-current and speed-power factor curves, as per declared standard test procedure (see above) and at 70%, 85%, 100% and 110% of the rated voltage.	Yes, Witnessed	We would like to submit test report for speed-torque, speed-current curve at rated load condition only. Speed power factor curve can be submitted by a calculation sheet instead of measurement.



For reference only

CHARACTERISTICS	REQUIRED	PROPOSED
Inspection of the motor auxiliary device wiring to the terminal strips	Yes, Witnessed	Comply.
Determination of the magnetic centering	Yes, Witnessed	Comply. Included No-Load test.
Operating inspection of the RTDs of windings and bearings	Yes, Witnessed	Comply.
Overspeed test	Yes, Witnessed	Comply.
Type tests		
Determination of losses, efficiency and power factor, as per declared standard test procedure (see above)	Yes, Witnessed	Comply.
Temperature rise test	Yes, Witnessed	Comply.
Cooling water system performance test to check flow rate and heat transfer.	Yes, Witnessed	Comply But Cooling water system performance test will be conducted in-process test So, reviewed not witness
Sound pressure level at 1 m	Yes, Witnessed	Comply.



For reference only

CHARACTERISTICS	REQUIRED	PROPOSED
- Rated voltage (kV rms)	7.2	9
- Continuous operating voltage (kV rms)	6,6	7.65
6 Tests		
Routine tests:		
Visual inspection (motor rating plate, ID plate, terminal boxes, CT's, RTD's, documentation, paint, cooling, etc)	Yes	Comply
No-load test as per declared standard test procedure (see motor characteristics above)	Yes, Witnessed	Comply
Locked-rotor test as per declared standard test procedure (see above)	Yes, Witnessed	Comply
Dielectric strength test at power frequency for 1 minute as per declared standard test procedure (see motor characteristics above)	Required, Witnessed	Comply
Insulation resistance test before and after the dielectric test as per declared standard test procedure (see above)	Yes, Witnessed	Comply
Winding resistance measurement	Yes, Witnessed	Comply
Rotation test and phase-sequence test	Yes, Witnessed	Comply. Included No-Load test
Rotor vibration test and balance test	Yes, Witnessed	Comply. But balance test will be conducted in-process test So, reviewed not witness.
Phase-earth capacity and tg δ of the insulation	Yes, Witnessed	Comply. But phase-earth capacity and delta tangent test will be conducted in-process test So, reviewed not witness.
Dimensional check and verification of finish	Yes, Witnessed	Comply.

For reference only

CHARACTERISTICS	REQUIRED	PROPOSED
<ul style="list-style-type: none"> - Type - Number of terminals 	<p>Pt-100</p> <p>3</p>	<p>Pt-100</p> <p>3</p>
<p>c. Bearing temperature detectors (RTDs):</p> <ul style="list-style-type: none"> - Quantity per bearing - Manufacturer - Type - Number of terminals 	<p>2</p> <p>Pt-100</p> <p>3</p>	<p>2</p> <p>Sentech</p> <p>Pt-100</p> <p>3</p>
<p>d. Temperature detectors (RTDs) to measure heat exchanger inlet and outlet air, in case of air/water cooling:</p> <ul style="list-style-type: none"> - Quantity - Manufacturer - Type - Number of terminals 	<p>2</p> <p>Pt-100</p> <p>3</p>	<p>2</p> <p>Sentech</p> <p>Pt-100</p> <p>3</p>
<p>e. Heat exchanger water leakage detector for air/water cooling:</p> <ul style="list-style-type: none"> - Quantity - Manufacturer - Type - Contact rated current (A) - Breaking current of the contact at 125 V dc in inductive circuit (A) 	<p>1</p> <p>0.5</p>	<p>1</p> <p>Hanbit KSE</p> <p>Floating</p> <p>120VDC, 0.6A</p>
<p>f. Current transformers for differential protection:</p> <ul style="list-style-type: none"> - Quantity - Manufacturer - Type - Connection - Transformation ratio - Rated output - Accuracy class and rated accuracy limit factor 	<p>3</p>	<p>3</p> <p>CT-eTech</p> <p>Self Balance</p> <p>100/1A</p> <p>10P20</p>
<p>g. Surge arresters :</p> <ul style="list-style-type: none"> - Quantity - Manufacturer - Type - Connection type 	<p>3</p> <p>Phase-earth</p>	<p>3</p> <p>Ohio-Brass</p> <p>Phase-earth</p>




For reference only

CHARACTERISTICS		REQUIRED	PROPOSED
-	Minimum pressure (kg/cm ²)	6	0.5 (Cooler required)
c.	Pressure loss in the air/water heat exchanger (kg/cm ²)		Air side: 0.0003 /Water side: 0.31
d.	Temperature rise of the water flowing through the air/water heat exchanger (°C)		4
e.	Heat loss to be dissipated (W)		400
f.	Heat exchanger tube material		90/10 copper Nickel
g.	Design pressure (kg/cm ²)		6
h.	Design temperature (°C)	39	
i.	Air relieve valve	Yes	Yes
4 Cables			
External power cable terminals			
a.	Maximum permissible cross-section (mm ²)		2x(3x185 mm ²)
Earthing terminals			
a.	Number	2	2
b.	Maximum permissible cross-section (mm ²)	185	182
5 Terminal Boxes			
Number of boxes		Min 3	3
Type			
Minimum IP protection degree of the terminal boxes		IP65	IP65
Accessories:			
a.	Space heaters:		
-	Quantity	1	1
-	Manufacturer		Youngkwang
-	Type		
-	Connection		Parallel
-	Supply voltage (V)	230	230
-	Total power consumed at supply voltage (W)		1000
b.	Stator temperature detectors (RTDs):		
-	Quantity	6	6
-	Manufacturer		Sungsil

For reference only

CHARACTERISTICS	REQUIRED	PROPOSED
2 Bearings		
Bearing type (ball, sleeve, etc.): a. Horizontal motor b. Vertical motor - Thrust bearing - Guide bearing		Ball 7340BDT 6052M
Maximum allowable bearing temperature: a. Horizontal motor (°C)		N/A
b. Vertical motor - Thrust bearing (°C) - Guide bearing (°C)		105 105
Type of bearing lubricant (oil, grease): a. Horizontal motor b. Vertical motor - Thrust bearing - Guide bearing		Grease Grease
Motors with forced bearing lubrication: a. Oil flow required for forced bearing lubrication (l/min) b. Viscosity of the oil c. Oil pressure at bearing inlet: - Maximum pressure (kg/cm ²) - Minimum pressure (kg/cm ²) d. Pressure loss in the bearings (kg/cm ²) e. Temperature rise of the oil flowing around the bearings (°C) f. Heat losses to be dissipated (W)		N/A
Construction of sleeve bearing, supports and shields (split, one-piece, etc)		N/A
Bearing Size (diameter by length)		ø260/200
3 Motor Cooling		
Motor cooling method		IC81W
Motors with air-water cooling: a. Required water flow rate (l/min) b. Cooling water pressure at the air/water heat exchanger inlet: - Maximum pressure (kg/cm ²)		283 10

For reference only

CHARACTERISTICS	REQUIRED	PROPOSED
Motor designed to restart with 110% reapplied voltage and 40% residual voltage at opposite phase angle	Yes	Yes
Maximum accumulated time withstand with an overvoltage caused by an earth fault	≥ 4 moths	
Direction of rotation (looking at the motor from the side opposite the coupling)	CW or CCW	CW
Permissible over-speed	20%	20% for 2min.
Maximum reverse speed motor can withstand in pump turbinisation when motor is disconnected from power supply (vertical motors with no device to prevent reverse rotation) (rpm)		444rpm during 2min.
Sound pressure level (weighted value, radiated sound pressure at 1 m) (dB(A))	80	80dB(A) No-load, Mean value
Class of stator winding insulation Class of stator winding temperature rise	40°C+105k+10k=15 5 40°C+80k+10k=130	F (155°C) B (130°C)
Insulation system of the stator winding	VPI	VPI
Ohmic resistance per phase (at 20°C) (Ω)		0.0728
Stator winding single-phase grounding capacity (μF)		0.2303
Rotor axial clearance (mm)		N/A
Shaft type (horizontal, solid vertical, hollow vertical)		Vertical
Enclosure classification (IP Number)	IP55	IP55
Weights:		
a. Weight of the rotor (kg)		6100
b. Total weight of the motor (kg)		25000
Erection		
Calorific value dissipated into the environment (Air)		6.0 kW
Frequency of starting cycles per year	≥ 1000	≥ 1000
Number of successive complete starts		
a. Hot	2	2
b. Cold	3	3

For reference only

CHARACTERISTICS	REQUIRED	PROPOSED
Motor thermal limit curve (Drawing no.)		TLC-1405-663-2
- Thermal time constant of motor heating (min)		20
- Thermal time constant of motor cooling (min)		60
Guaranteed power factor at rated voltage and frequency:		
a. At full load		0.76
b. At 75% full load		0.71
c. At 50% full load		0.61
Guaranteed efficiency at rated voltage and frequency:		
a. At full load		95.0
b. At 75% full load		95.0
c. At 50% full load		94.0
Motor equivalent circuit parameters in respect of the stator		
R_1 (at 20°C) (p.u.)		0.00683
X_1 (p.u.)		0.16147
R_2		
- When $S = 0$ (p.u.)		0.01829
- When $S = 1$ (p.u.)		0.03188
X_2		
- When $S = 0$ (p.u.)		0.08925
- When $S = 1$ (p.u.)		0.06293
X_M (p.u.)		1.604
Subtransient reactance, X'' (p.u.)		0.2104
Time constants of the motor current contributing to a 3-phase short-circuit at terminals		
a. AC component $T_{ac} \sim X''/2 \pi f R_2$ (s)		0.0352
b. DC component $T_{dc} \sim X''/2 \pi f R_1$ (s)		0.0523
Time constant with open circuit $T_{oc} \sim X_m/2 \pi f R_2$ (s)		0.2947


For reference only

CHARACTERISTICS		REQUIRED	PROPOSED
Maximum starting current, A			1787.0
Maximum starting voltage, V			6600
Maximum starting torque, %FLT			75
Locked-rotor current at rated voltage and frequency (guaranteed maximum value)	(p.u.)	≤ 5,5 +20% tol.	≤ 5.0 + 20% tol.
Power-frequency withstand voltage	(kV)	23	14.2
Impulse withstand voltage of the interturn insulation	(kV)	32	20
Lightning impulse withstand voltage	(kV)	49	31
No-load current at rated voltage and frequency	(A)		175.0
Power factor at rated output			0.76
Minimum torque at rated voltage and frequency	(%)		75
Speed at which minimum torque is produced (rpm)			0
Pull-up torque at rated voltage and frequency (%)			75
Breakdown torque at rated voltage and frequency	(p.u)	≥ 2.1	≥2.1
Speed at which breakdown torque is produced (rpm)			348
Guaranteed minimum startup voltage (% U _N)		80	80
Inertia moment (GD ²) (kg/m ²)			4008
Acceleration time (full load)			
a.	At rated voltage (s)		1.2
b.	At minimum specified startup voltage (80%) (s)		2.5
Maximum allowable time with locked rotor at rated voltage:			
a.	With the motor initially at maximum ambient temperature (s)	≥125% the accel. time at U _N	26.8
b.	With the motor initially at operating temperature (s)	≥125% the accel. time at U _N	19.9
Maximum allowable time with locked rotor at the minimum start up voltage specified:			
a.	With the motor initially at maximum ambient temperature (s)	≥125% the accel. time at U _N	42.7
b.	With the motor initially at operating temperature (s)	≥125% the accel. time at U _N	31.6


For reference only

CHARACTERISTICS	REQUIRED	PROPOSED
1. Motor Characteristics		
Driven equipment		CWP
Manufacturer		HHI
Number of units		1 EA
Type	Induction	Induction
Rated Power (kW)		2950
Designed, manufactured and tested according to the following standard		IEC
Stator winding connection (star, star with accessible neutral, delta, etc)		Star with accessible neutral
Type of rotor	Squirrel cage	Squirrel cage
Guaranteed power rating at site conditions (kW)		2950
Duty type	S1	S1
Rated useful life	30 years	30 years
Frame size		800 Frame
Stator winding temperature rise above ambient temperature:		
• Measured by resistance variation (K)	≤ 80	<78.2
• Measured by resistance sensors housed in the winding (K)	≤ 90	<88.2
Temperature rise after 1 hour operating with a load of the highest torque at 85% of rated voltage and between 48.5 and 50Hz (K)		Temperature saturation + about 43K
Temperature rise after 1 minute operating at a voltage of 70% of rated voltage and at 47.5 Hz (K)		Temperature saturation + about 2K
Temperature rise after 15 minutes running at 85% of the nominal voltage (K)		Temperature saturation + about 8K
Maximum ambient temperature (°C)	40	40
Rated voltage (kV)	6.6 ± 10%	6.6 + 10%
Number of phases	3	3
Rated frequency (Hz)	50	50
Speed at full load (rpm)		370
Slip at full load (%)		1.33
Full load current at rated voltage and frequency (A)		357.4


UPPER SIDE

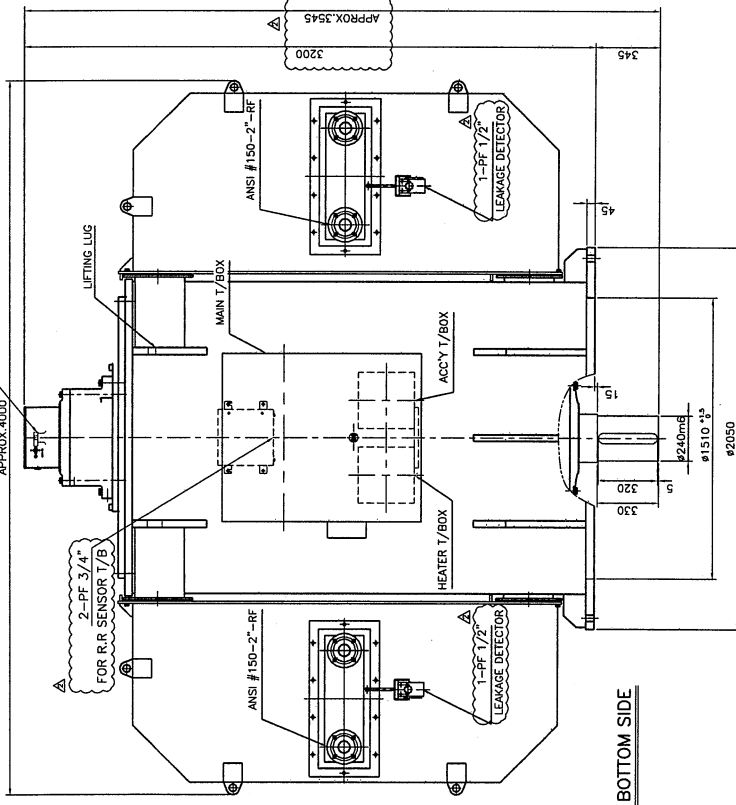

BOTTOM SIDE

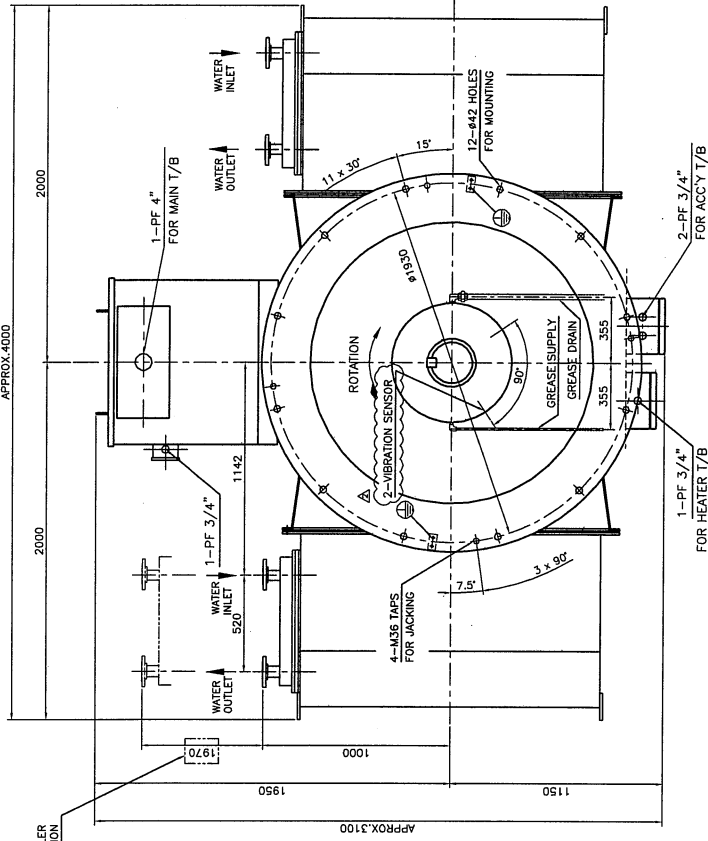

VIEW FROM BOTTOM SIDE

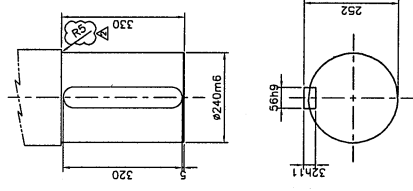

SHAFT END DETAIL

THREE PHASE INDUCTION SQUIRREL CAGE ROTOR MOTOR ; IC611

TYPE	OUTPUT	POLES	VOLT.	FREQ.	PROT.	INSUL. CLASS	MOUNT.	BEARING	TOTAL WEIGHT (APPROX.)
HRN3 807-76Y	2950 kW	16 P	6600 V	50 Hz	IP 55	F	V 10	D.E SIDE : 6052M N-D.E SIDE : 7340BDT	25000 Kg

TECHNICAL INFORMATION

- BEARING

BEARING	D.E SIDE	N-D.E SIDE
Bearing Type	#6052M (Ball)	7340BDT (Angular Contact Ball)
Lubricant Type	GREASE	GREASE
Grease Type	SHELL(Godius S2 V100 3)	
Initial Charge Quantity	1240 g	4032 g
Refilling Quantity	130 g	1210 g
-Charge interval	4 MONTHS	4 MONTHS
- WINDING TEMPERATURE DETECTOR
 - A) Number and Type : 2EA/Phase, Pt 100 ohm at 0°C-Single
- BEARING TEMPERATURE DETECTOR
 - A) Number and Type : 1EA/Bearing, Pt 100 ohm at 0°C-Dual
- AIR TEMPERATURE DETECTOR
 - A) Number and Type : 2EA/Motor, Pt 100 ohm at 0°C-Single
- CONTROL SETTING(Included Ambient Temp.):

Winding(W.T.D)	Bearing(B.T.D)
Alarm 130 °C	100 °C
Trip 150 °C	105 °C
- SPACE HEATER : 1 PHASE, 230 V, 1000W
- WATER LEAKAGE DETECTOR : 2EA/MOTOR
- REVERSE ROTATION SENSOR : 1EA/MOTOR (IFM, DR2505)
 - A) Number and Type : 3EA/MOTOR, CT-eTech, 10Q/1A, 10P20

9) VIBRATION SENSOR (Seismic Transmitter)

- A) Number and Type : 2EA/Bearing, Bentley Nevada 177230
- 10) COOLING WATER FOR MOTOR

Quality	Fresh Water
Flow rate	17.0 m ³ /hr
Max. allowable Flow rate	22.1 m ³ /hr
Operating Pressure	Max. 10 barg
Inlet Temp.	37.2°C
Max. allowable Inlet Temp.	39°C

11) CURRENT TRANSFORMER (SELF BALANCE TYPE)

- A) Number and Type : 3EA/MOTOR, CT-eTech, 10Q/1A, 10P20

CAUTION

To maintain the water cooler of motor in good condition, cooling water shall be provided into the water cooler less than maximum allowable flowrate. In addition, cooling water shall be provided in accordance with cooling water inlet pressure. Otherwise, the water cooler will be seriously damaged.

KKS NO.: 20PAC10AP001

- THIS MOTOR IS DESIGNED TO BE OPERATED IN ARROW DIRECTION.
- THE NON-DRIVE END SHIELD IS INSULATED TO PREVENT BEARING DAMAGE FROM SHAFT CURRENT.
- THIS MOTOR CANNOT WITHSTAND THE UP AND DOWN THRUST OF PUMP.
- WHILE A MOTOR IS NOT IN ITS OPERATION, AND IF THE AMBIENT TEMPERATURE GOES BELOW THE WATER FREEZING POINTS, PLEASE DRAIN COOLING WATER COMPLETELY TO PREVENT COOLER PIPE DAMAGE FROM WATER FREEZING.
- THE TEMPERATURE OF THE COOLING WATER MUST BE OVER 5°C (41°F)

DATE	BY	CHKD BY	SCALE	UNIT	SUBJECT	TITLE	OUTLINE DIMENSION
2013.03.20	HYUNDAI	HYUNDAI	1/1A	PROJECT	20PAC10AP001		
2013.03.20	HYUNDAI	HYUNDAI	1/1A	DATE	2013.03.20		
2013.03.20	HYUNDAI	HYUNDAI	1/1A	REV. NO	01		
2013.03.20	HYUNDAI	HYUNDAI	1/1A	DWG. NO	HM-092841		
2013.03.20	HYUNDAI	HYUNDAI	1/1A	Revision No.	1		

REV.	DATE	CONTENTS
1	2013.03.20	INITIAL ISSUE
2	2013.03.20	REVISION OF MARK
3	2013.03.20	REVISION OF MARK
4	2013.03.20	REVISION OF MARK
5	2013.03.20	REVISION OF MARK

Roll



Ashuganj Power Station
Company Ltd. (APSCL)



ASHUGANJ COMBINED CYCLE POWER PLANT PROJECT (NORTH)

UTS PROJECT NO. 7485

UNIT: CIRCULATING WATER PUMP

PURCHASE ORDER NUMBER (P.O.R) 074850505 / F557

EQUIPMENT : 20PAC10AP001

REVIEW RESPONSE BY PURCHASER:

Purchaser review and comments do not indicate either responsibility or liability for accuracy and completeness of this document or alter any contractual terms and conditions:

REJECTED

Reviewed With Comments

Review. Without Comments

COMMENTS AS NOTED

REVIEWED AS BUILT

FOR INFORMATION

DATE: 29/05/15

DOCUMENT VENDOR IDENTIFICATION:



DOCUMENT TITLE: **Motor General Arrangement**

VENDOR DOCUMENT No: COS-14-10P40399-6004

REV: 5

CODE: PLD-0001

UTS DOCUMENT No: V-0748505050-0002

REV: 5

KKS DOCUMENT No.: 07485-20-PAC-EDP-FLS-003

REV: 5

Handwritten signature

Handwritten mark

Section 8. Drawings/Layout